

**01 Existing Floor Plan**  
SCALE: 1/8"=1'-0"

- floor legend :**
- FIRE ALARM PULL STATION
  - FIRE ALARM STROBE/HORN
  - FIRE EXTINGUISHER
  - FIRE EXTINGUISHER CABINET

**area calculations :**

-- DENOTES SPACE LEASE LINE

TOTAL OVERALL LEASABLE SPACE SQUARE FOOTAGE = **3,572 S.F.**



**Suniland Shopping Center**  
**Citibank Interior As-Built**  
11341 S. Dixie Highway  
Pincrest, Florida 33156


project no. :  
#16174  
date :  
10-03-2016  
sheet number :

**A-1**

MODIS Architects, LLC  
4955 SW 75th Avenue  
Miami, Florida 33155  
t. 786.879.8882  
f. 786.350.1515  
w. www.modisarchitects.com



copyright © MODIS Architects, LLC

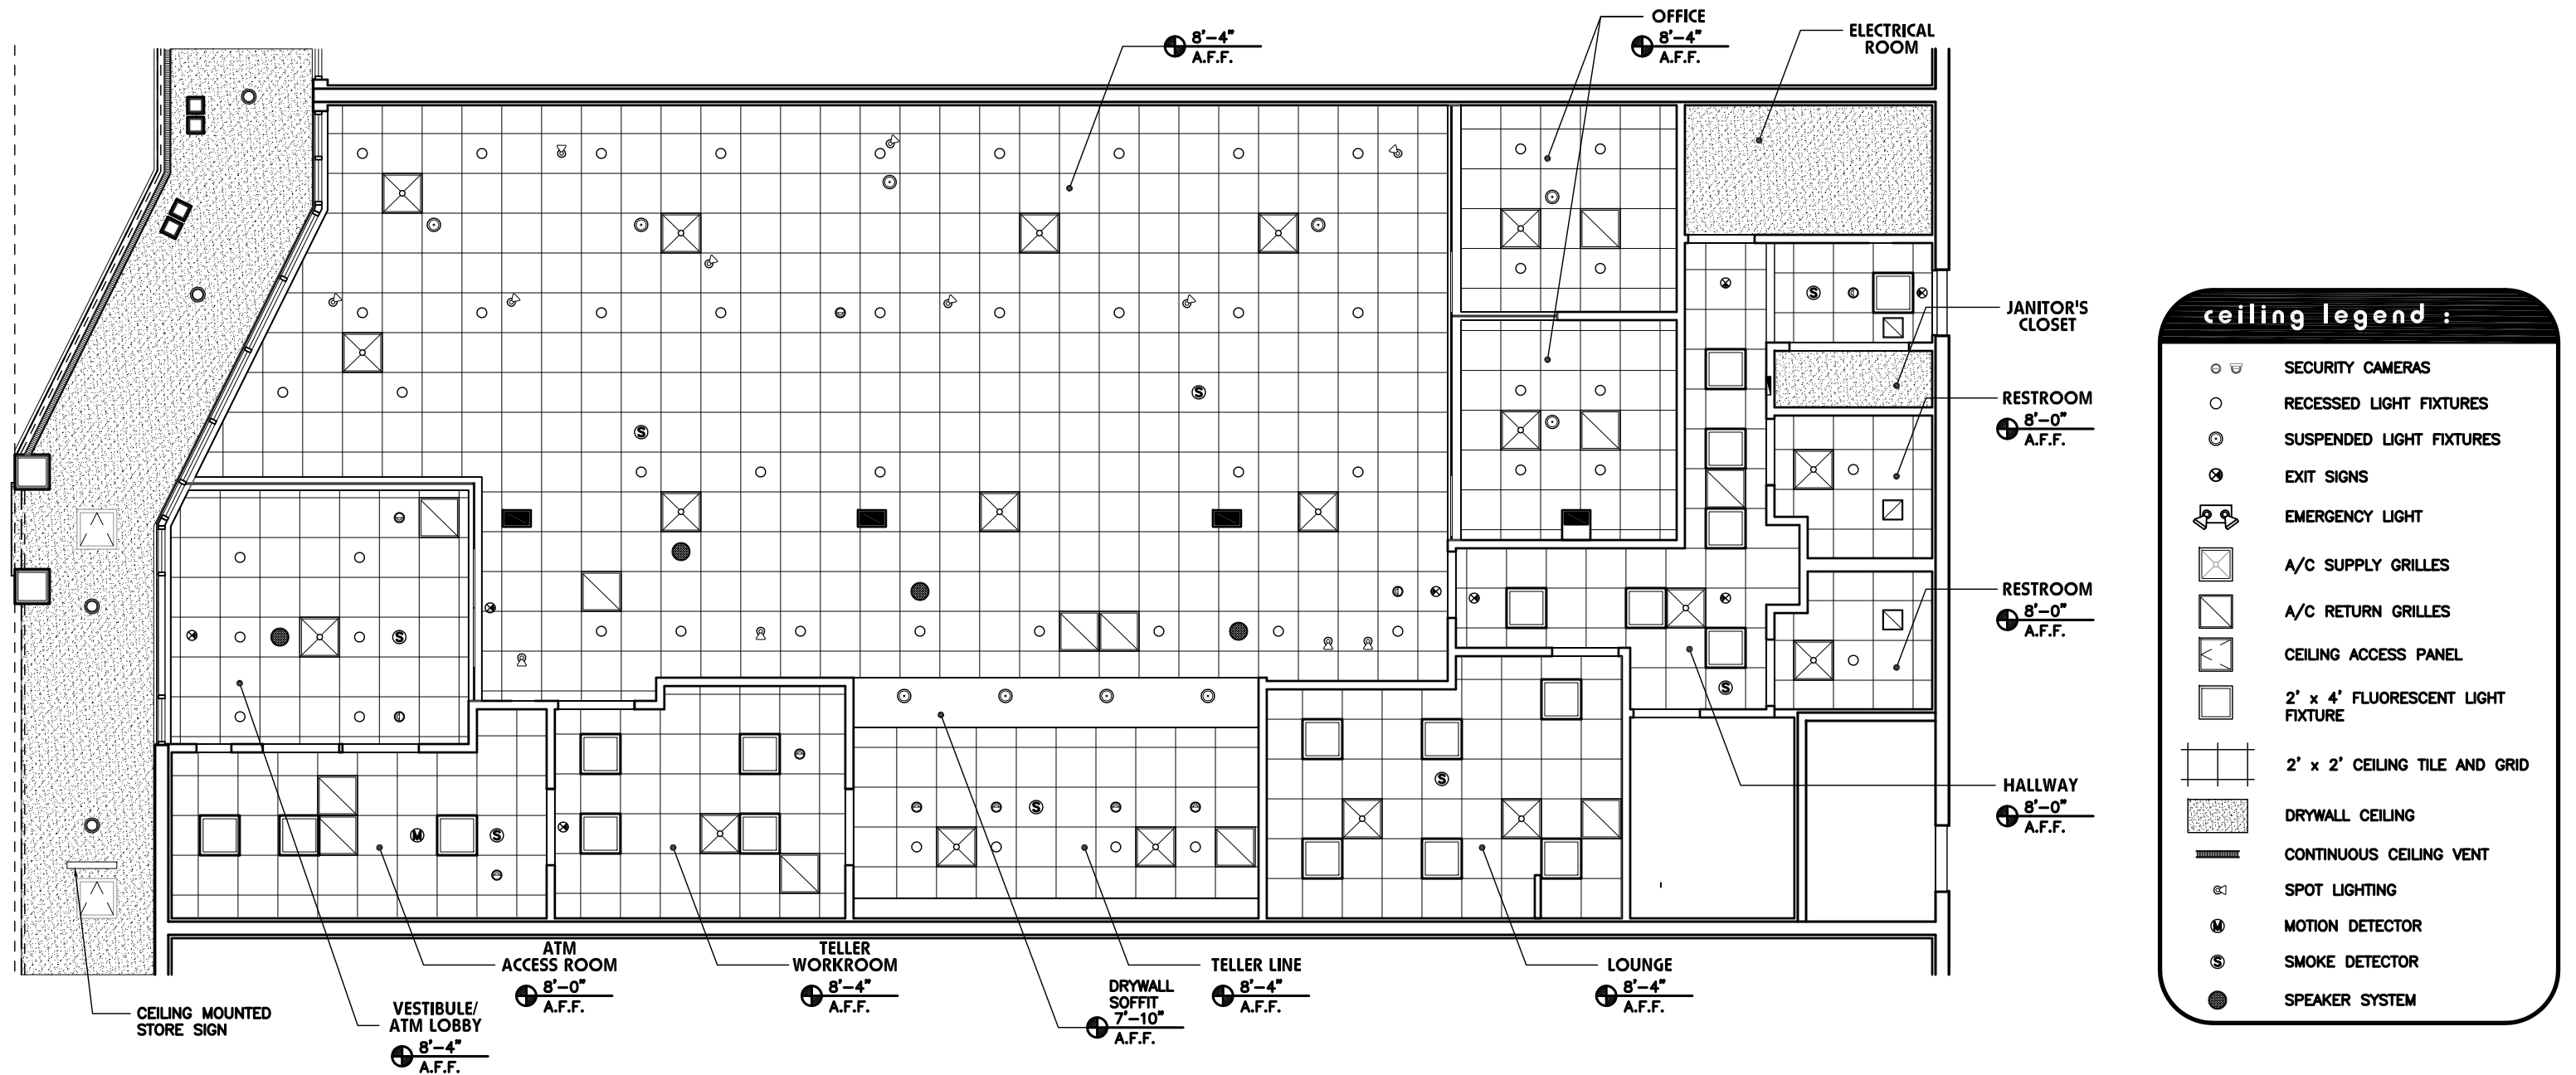

## 02 Existing Reflected Ceiling Plan

SCALE: 1/8" = 1'-0"



### Suniland Shopping Center Citibank Interior As-Built

11341 S. Dixie Highway  
Pincrest, Florida 33156

project no. :  
#16174  
date :  
10-03-2016  
sheet number :

**A-2**

MODIS Architects, LLC  
4955 SW 75th Avenue  
Miami, Florida 33155  
t. 786.879.8882  
f. 786.350.1515  
w. www.modisarchitects.com



copyright © MODIS Architects, LLC