


area calculations :

-- DENOTES SPACE LEASE LINE

TOTAL OVERALL LEASABLE
SPACE SQUARE FOOTAGE = 2,320 S.F.

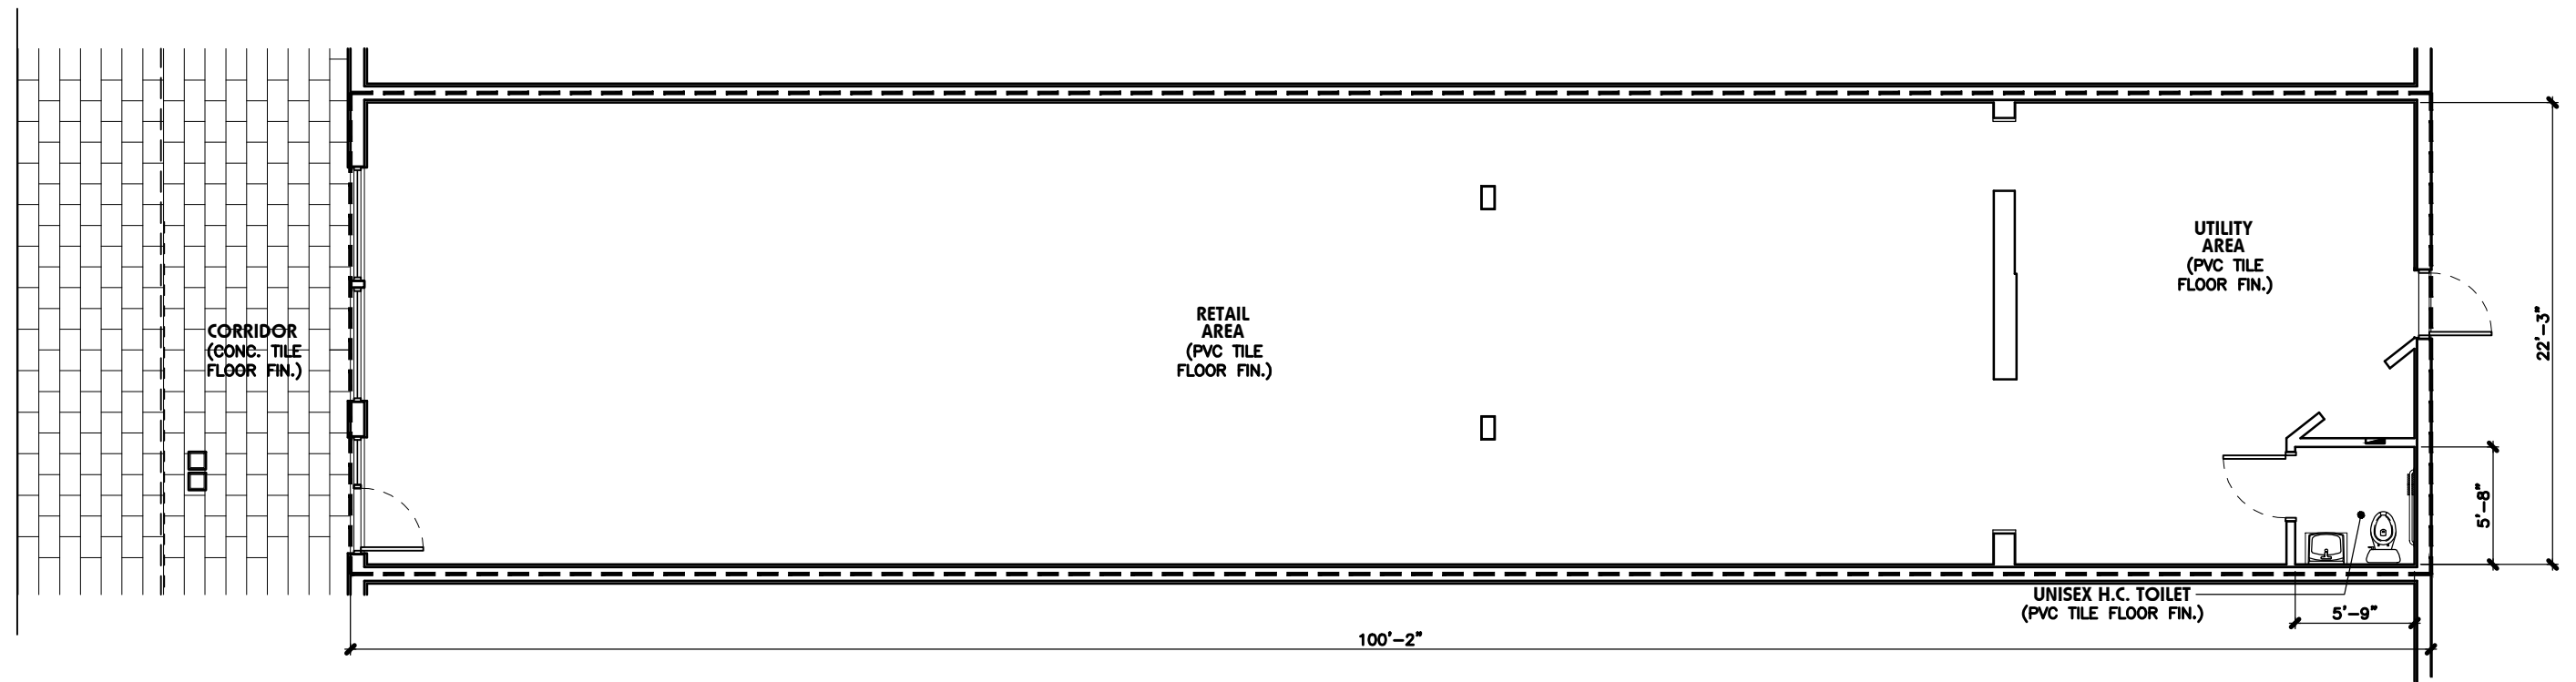

01 Existing Floor Plan
SCALE: 1/8"=1'-0"



**Suniland Shopping Center
Interior As-Built (Vacant Space)**

11297 S. Dixie Highway
Pinecrest, Florida 33156

project no. :
#16174
date :
10-31-2016
sheet number :

A-1

MODIS Architects, LLC
4955 SW 75th Avenue
Miami, Florida 33155
t. 786.879.8882
f. 786.350.1515
w. www.modisarchitects.com



copyright © MODIS Architects, LLC